

BOUNDARY AND TOPOGRAPHIC SURVEY OF "LEGION MEMORIAL PARK"

SURVEYOR'S NOTES:

SECTION 1) DATE OF FIELD SURVEY:

1. The date of completion of the field work of the Boundary and Topographic Survey was on August 3 2017.
2. The date of completion of the field work of the Update Survey was on June 6 2019.

SECTION 2) LEGAL DESCRIPTION:

Beginning at a point 15 feet East of the Southwest corner of Government Lot 5 in Section 18 Township 53 South of Range 42 East, Dade County, Florida; Thence run North parallel with and 15 feet East of the West boundary line of said Government Lot 5, a distance of 747.7 feet, more or less to the Southwest corner of Lot 2, of Mary Brickell's Plat, recorded in Plat Book "B", on page 11, of the public Records of Dade county, Florida; Thence run East 1155 feet, more or less, to the West shore of Biscayne Bay; Thence Northerly along and meandering said West shore of Biscayne Bay to the Southeast corner of that certain property heretofore conveyed by the Grantor herein to Walter Harris Company, a corporation, by deed recorded in Deed Book 257 at page 424 of the Public Records of Dade County Florida; Thence in a Westwardly course along and following the South boundary of the tract heretofore conveyed by the Grantor herein to said Walter Harris Company, a corporation, as described in Deed Book 257 at page 424 of the public Records of Dade County, Florida, to a point 15 feet East of the West boundary of Government Lot 1 in section 18, Township 53 South of Range 42 East, Dade County, Florida; Thence South parallel to and 15 feet East of said west boundaries of Government Lots 1 and 5 in said section 18, 690.5 feet more or less, to the place of beginning; Less, however, Tracts "K" and "L" as shown on a Plat of a Subdivision of Government Lot 5 in Section 18, Township 53 South, of Range 42 East, recorded in Plat Book "A", at page 1 of the Public Records of Dade County, Florida; Also less a strip of land measuring 25 feet North and South and 125 feet East and West, lying to the North of Tracts "K" and "L" as shown on the Plat above referred to and recorded in plat Book "A" at page 1, of the Public Records of Dade County, Florida, and otherwise referred to, described and indicated as Tract "M" on a certain plat attached to a mortgage heretofore encumbering the property herein conveyed, which said mortgage is recorded in Mortgage Book 55 at page 146, of the Public Records of Dade County, Florida. Together with the following described property conveyed to the Trustees for the Harvey W. seeds Post No. 29 American Legion by the Trustees of the Internal Improvement Fund of the State of Florida as recorded in Deed Book 1590 at Page 83 and Deed Book 2578 at Page 300 of the public Records of Dade County, Florida: From the Southwest corner of Government Lot 5, which is in the center of section 18, Township 53 South, Range 42 East, Dade County, Florida, go northerly along the said West line of said Government Lot 5; a distance of 1,438.1 feet; thence, right with a deflection angle of 90 20' a distance of 667 feet: thence, right with a deflection angle of 3 36' a distance of 559 feet more or less, to a point of beginning; said point being the northeasterly corner of the land conveyed to S. S. McCahill, et al, as Trustees for Harvey W. Seeds Post No. 29, American Legion, Department of Florida. by deed recorded in Deed Book 1543, page 24 public Records of Dade County, Florida. From said point of beginning go easterly along a line 650 (Deed 600) feet, more or less, north of and parallel to the north line of N. E. 64th Street in Miami, Florida, produced easterly a distance of 2,513 (Deed 2,400) feet, more or less, to a line 250 feet westerly from the center line of the Inland Waterway Channel as constructed by the United states and parallel to said center line; thence southerly along said line a distance of 653 (Deed 600) feet, more or less to its intersection with the north line of said N. E. 64th Street produced easterly a distance of 2,500 feet, more or less, to the western shore of Biscayne Bay; thence, northerly along the western shore of Biscayne Bay and the property of Harvey W. Seeds Post No. 29, American Legion. Department of Florida, a distance of 653 (Deed 600) feet, more or less, to the point of beginning, all lying and being in Township 53 South, Range 42 East, Dade County Florida.

LESS: LEGION PARK, according to the Plat thereof, recorded in Plat Book 39, at Page 86, of the Public Records of Dade County, Florida;

ALSO LESS : The Amended Plat of LEGION PARK, according to the Plat thereof, recorded in Plat Book 39, at page 93, of the Public Records of Dade County, Florida;

ALSO LESS: All that part of Government Lot 5 in Section 18, Township 53, South, Range 42 East as per Plat recorded in Plat Book A, at page 1, of the Public Records of Dade County Florida, which part is particularly bounded and described as follows, to-wit:

Commencing at a point the Northwest corner of Lot D of Legion Park, as per Plat Recorded in Book 39, at Page 93, of the Public Records of Dade County, Florida, running thence Westerly and parallel to the North line of Lot 1 of Arlington, as said Lot 1 is show on map recorded in Plat Book 7, Page 44, of the Public Records of Dade County, Florida, a distance of 56 feet, thence south parallel to the Westerly line of Said Lot D a distance of 25 feet to the Northwest corner of Lot 1 of said Arlington, thence Easterly along the Northerly line of said Lot 1 of Arlington 56 feet to the Westerly line of said Lot D, thence North along the Westerly line of said Lot D, 25 feet to the point of Beginning.

ALSO LESS: All that part of Government Lot 5 in Section 18, Township 53, South, Range 42 East, as per Plat recorded in Plat Book A, at page 1 of the public records of Dade County, Florida, which part is particularly bounded and described as follows, to-wit:

Commencing at a Point the Northeast corner of Lot 2 of Arlington, as said Lot is shown on map recorded in Plat Book 7, page 44, of the Public Records of Dade County, Florida, running thence North parallel to the west line of Lot D of Legion Park, as per plat recorded in Book 39, at page 93, of the Public Records of Dade County, Florida, 25 feet to a point being the Northwest corner of tract conveyed to Randolph B. Covington and Rose Covington, his wife, by Deed recorded in Deed Book 2258 at Page 173, thence West and parallel to the North line of said Lot 2 of Arlington 56 feet to a point, and them South and parallel to the Westerly line of Lot D as aforesaid 25 feet to the Northwest Corner of said Lot 2 of Arlington, thence East along t-e North line of said Lot 2, 56 feet to the Point of Beginning;

SECTION 18 - TOWNSHIP 53 SOUTH - RANGE 42 EAST



plat above referred to and ALSO LESS: Lots 1, 2 and 6 of the Mary Brickell Subdivision, as per Plat thereof recorded in Plat Book B, at page 11, of the Public Records of Dade County, Florida. Said Lot 6 is also shown as Lot 6 of Legion Park, on Plat recorded in Plat Book 39, at page 93, of the public Records of Dade County. Florida.

ALSO LESS: The following described property : Commence at the southwest corner of the SW 1/4 of the NE 1/4 of section 18. Township 53 South, Range 42 East, thence north along the west line of the NE 1/4 of aforesaid Section, 727.67 feet to the point of intersection with the center line of Northeast 64th Street, thence east along the center line of Northeast 64th Street, 600 feet to a point, thence north parallel to the west line of the NE 1/4 of aforesaid Section 18 a distance of 20.0 feet to the Southwest corner of Lot 26 of MARY BRICKELL SUBDIVISION as recorded in plat Book B, at page 11, of the Public Records of Dade County, Florida, said point being the point of beginning of the parcel of land hereinafter described as follows, thence north along the west line of said Lot 26 and the east line of Northeast 7th Avenue as shown on AMENDED PLAT OF LEGION PARK, Plat Book 39, at Page 93, of the Public Records of Dade County, Florida, a distance of 317.1 feet to a point, thence east parallel to the center line of Northeast 64th Street 500 feet to a point, thence south parallel to the east line of Northeast 7th Avenue, 317.1 feet to the north line of Northeast 64th Street (Bay Street) Plat Book B, Page 411, Public Records of Dade County, Florida, thence west along the north line of Northeast 64th Street, 500 feet to the Point of Beginning.

Property Address and Tax Folio Number:
6447 NE 7th Avenue, Miami, Florida 33138
Folio No. 01-3218-000-0030

SECTION 3) ACCURACY:

The accuracy obtained by field measurement methods and office calculations of closed geometric figures meets and exceeds the Standards of Practice requirement for this Type of Survey as defined in Rule 5J-17.051, Florida Administrative Code.

Elevations of well identified features as depicted on the Survey Map were measured to an estimated vertical position accuracy of 1/100 of a foot on hard surfaces and 1/10 of a foot on ground surfaces.

Well identified features as depicted on the Survey Map were measured to an estimated horizontal position accuracy of 1/10 of a foot.

This Map of Survey is intended to be displayed at a scale of (1"=50') or smaller.

SECTION 4) SOURCES OF DATA:

North arrow direction is based on an assumed Meridian.

Warranty Deed, dated July 27th, 1966, recorded in Official Records Book 5154, Page 287, Miami-Dade County Records.

Plat of "SUBDIVISION OF GOVERNMENT LOT 5 IN SECTION 18, TOWNSHIP 53 SOUTH, RANGE 42 EAST", recorded in Plat Book A, at Page 1, Miami-Dade County Records.

Plat of "MARY BRICKELL", recorded in Plat Book B, at Page 11, Miami-Dade County Records.

Plat of "ARLINGTON", recorded in Plat Book 7, at Page 44, Miami-Dade County Records.

Plat of "LEGION PARK", recorded in Plat Book 39, at Page 86, Miami-Dade County Records.

Plat of "AMENDED PLAT OF LEGION PARK", recorded in Plat Book 39, at Page 93, Miami-Dade County Records.

Plat of "BANYAN BAY APARTMENTS", recorded in Plat Book 94, at Page 55, Miami-Dade County Records.

Plat of "BANYAN BAY APARTMENTS REPLAT", recorded in Plat Book 158, at Page 65, Miami-Dade County Records.

Plat of "METROPOLITAN DADE COUNTY, FLORIDA BULKHEAD LINE PART THREE", recorded in Plat Book 74, at Page 3, Miami-Dade County Records.

Bearings as shown hereon are based upon the Westerly Boundary Line with an assumed bearing of S02°21'41"E, said line to be considered a well established and monumented line.

This property is to be located in Flood Zone "X", and Zone "AE", with a Base Flood Elevation being 8.0', 9.0' and 10', as per Federal Emergency Management Agency (FEMA) Community Number 120650 (City of Miami), Map Panel No. 12086C0308, Suffix L, Map Revised Date: September 11, 2009. (As Shown of the Survey Map)

Legal Description was furnished by client.

City of Miami Municipal Atlas, Sheets No. 14 C, D, and G, prepared by the City of Miami, Department of Public Works.

Elevations as shown hereon are based on City of Miami Datum, Miami-Dade County Benchmark "E-243" was used its Elevation was converted by adding 0.26'. BM Elevations 11.76 (NGVD 29) +0.26'= 12.02 (City of Miami Datum).

Benchmark E-243, Elevation: + 11.76 feet (NGVD 29)

Location:
NE 68 St.-----On South Side
NE 4 Ct.-----150' West of C/L
35' East of East Rail of Main Track
Description:
Us C & G Brass Disc set vertically in the West wall of a Bldg., 0.5' South of the NW corner of building, 2' above ground level.

The Mean High Water Elevation as shown hereon was established by interpolating elevations shown on the Mean High Water Interpolation Points No. 135 and No. 137 as per Florida Department of Environmental Protection Data sheet obtained on July 11, 2016.

SECTION 5) LIMITATIONS:

Since no other information were furnished other than what is cited in the Sources of Data, the Client is hereby advised that there may be legal restrictions on the Subject Property that are not shown on the Survey Map that may be found in the Public Records of Miami-Dade County.

The Surveyor makes no representation as to ownership or possession of the Subject Property by any entity or individual who may appear of public records of this County.

No excavation or determination was made as to how the Subject Property is served by utilities.

No improvements were located, other than those shown. No underground foundations, improvements and/or utilities were located or shown hereon.

SECTION 6) CLIENT INFORMATION:

This Boundary Survey was prepared at the request of and certified to:

CAPITAL IMPROVEMENTS AND TRANSPORTATION PROGRAM

SECTION 7) SURVEYOR'S CERTIFICATE:

I hereby certify: That this "Boundary and Topographic Survey" and the Survey Map resulting therefrom was performed under my direction and is true and correct to the best of my knowledge and belief and further, that said "Boundary and Topographic Survey" meets the intent of the applicable provisions of the "Standards of Practice for Land Surveying in the State of Florida", pursuant to Rule 5J-17.051 through 5J-17.052 of the Florida Administrative Code and its implementing law, Chapter 472.027 of the Florida Statutes.

HADONNE CORP., a Florida Corporation
Florida Certificate of Authorization Number LB7097

By: Abraham Hadad, PSM
For the Firm
Registered Surveyor and Mapper LS6006
State of Florida

NOTICE: Not valid without the signature and original raised seal of a Florida Licensed Surveyor and Mapper. Additions or deletions to Survey Maps by other than the signing party are prohibited without the written consent of the signing party.

LAND SURVEYOR AND MAPPERS
3D LASER SCANNING
UTILITY COORDINATION
SUBSURFACE UTILITY ENGINEERING
1985 NW 88th Court, Suite 101 - Doral, FL 33172 - P. +1 (305) 206-1188 - F. +1 (305) 207-6845 - W. www.hadonne.com

HADONNE

BNDY. & TOPOGRAPHIC SURVEY
for
CITY OF MIAMI CAPITAL IMPROVEMENTS AND TRANSPORTATION
of
6447 NE 7th AVENUE, MIAMI, FLORIDA 33138

HADONNE

REVISIONS

| | | | |
|----|--------------|------------|----|
| 1. | REVISE | DATE | BY |
| 2. | FIELD UPDATE | 06-06-2019 | |
| 3. | | | |
| 4. | | | |
| 5. | | | |
| 6. | | | |

Field Book:

| |
|------|
| FILE |
|------|

DRAWN BY:

| |
|----|
| MG |
|----|

TECH BY:

| |
|----|
| RI |
|----|

QA/QC BY:



| |
|----|
| JS |
|----|

JOB No.:

| |
|-------|
| 16053 |
|-------|

JOB No.:

| |
|-----|
| 1/2 |
|-----|

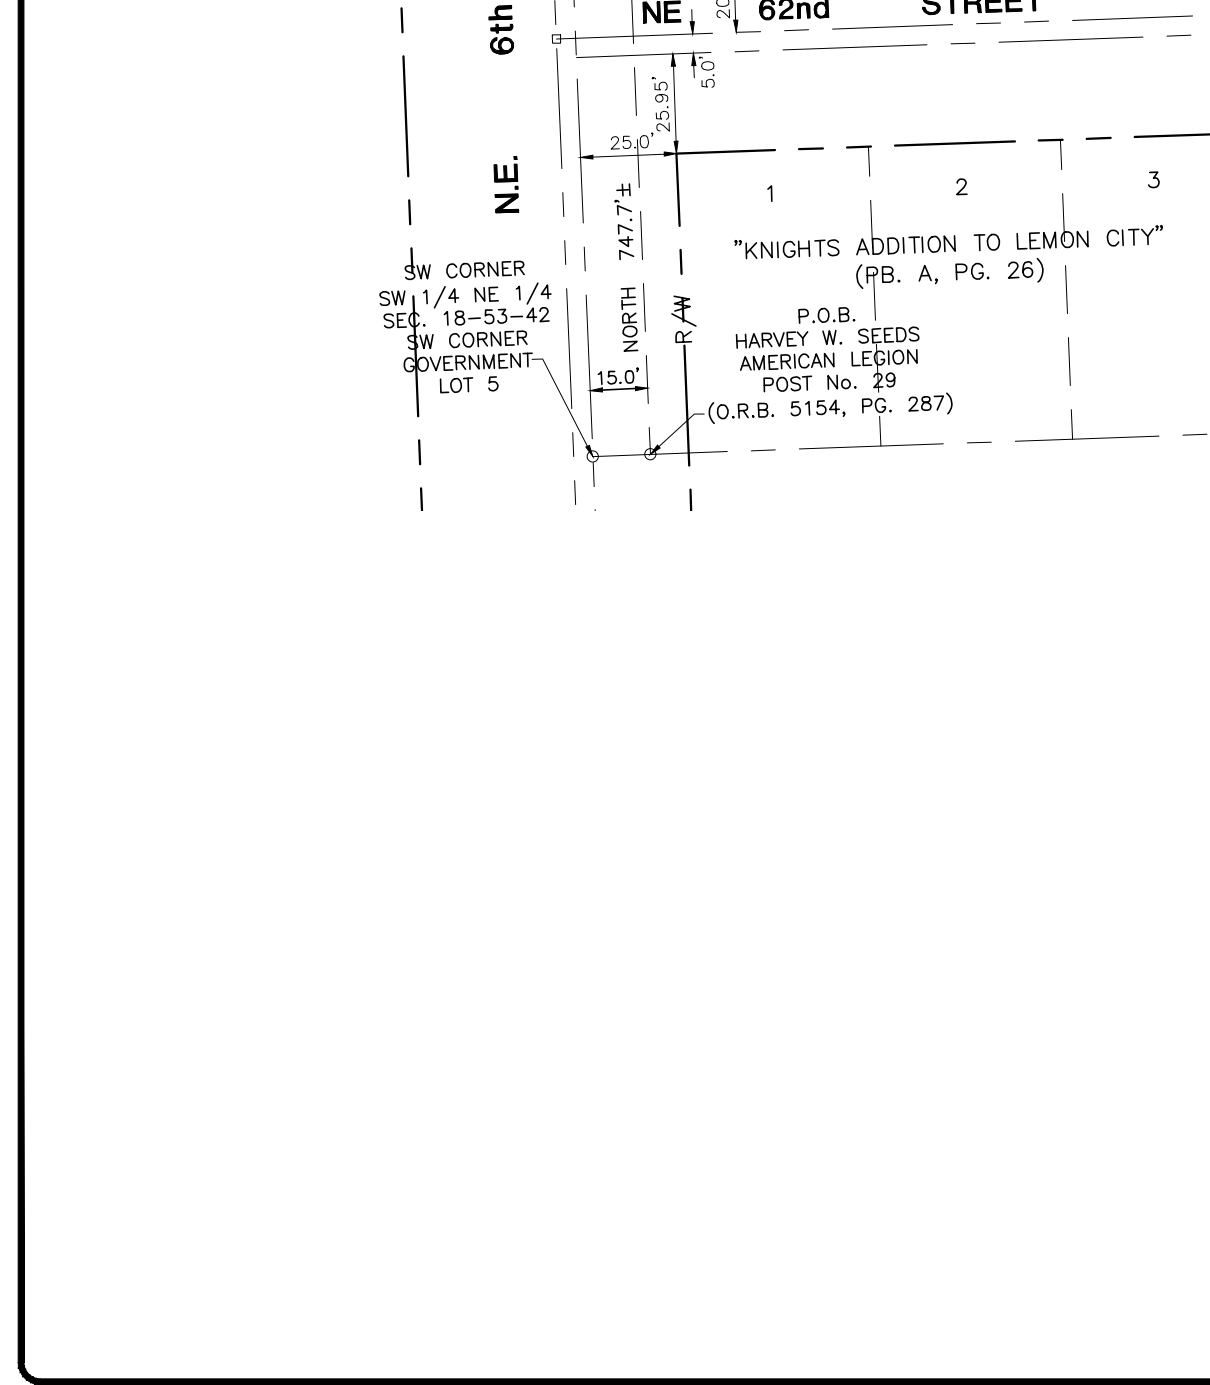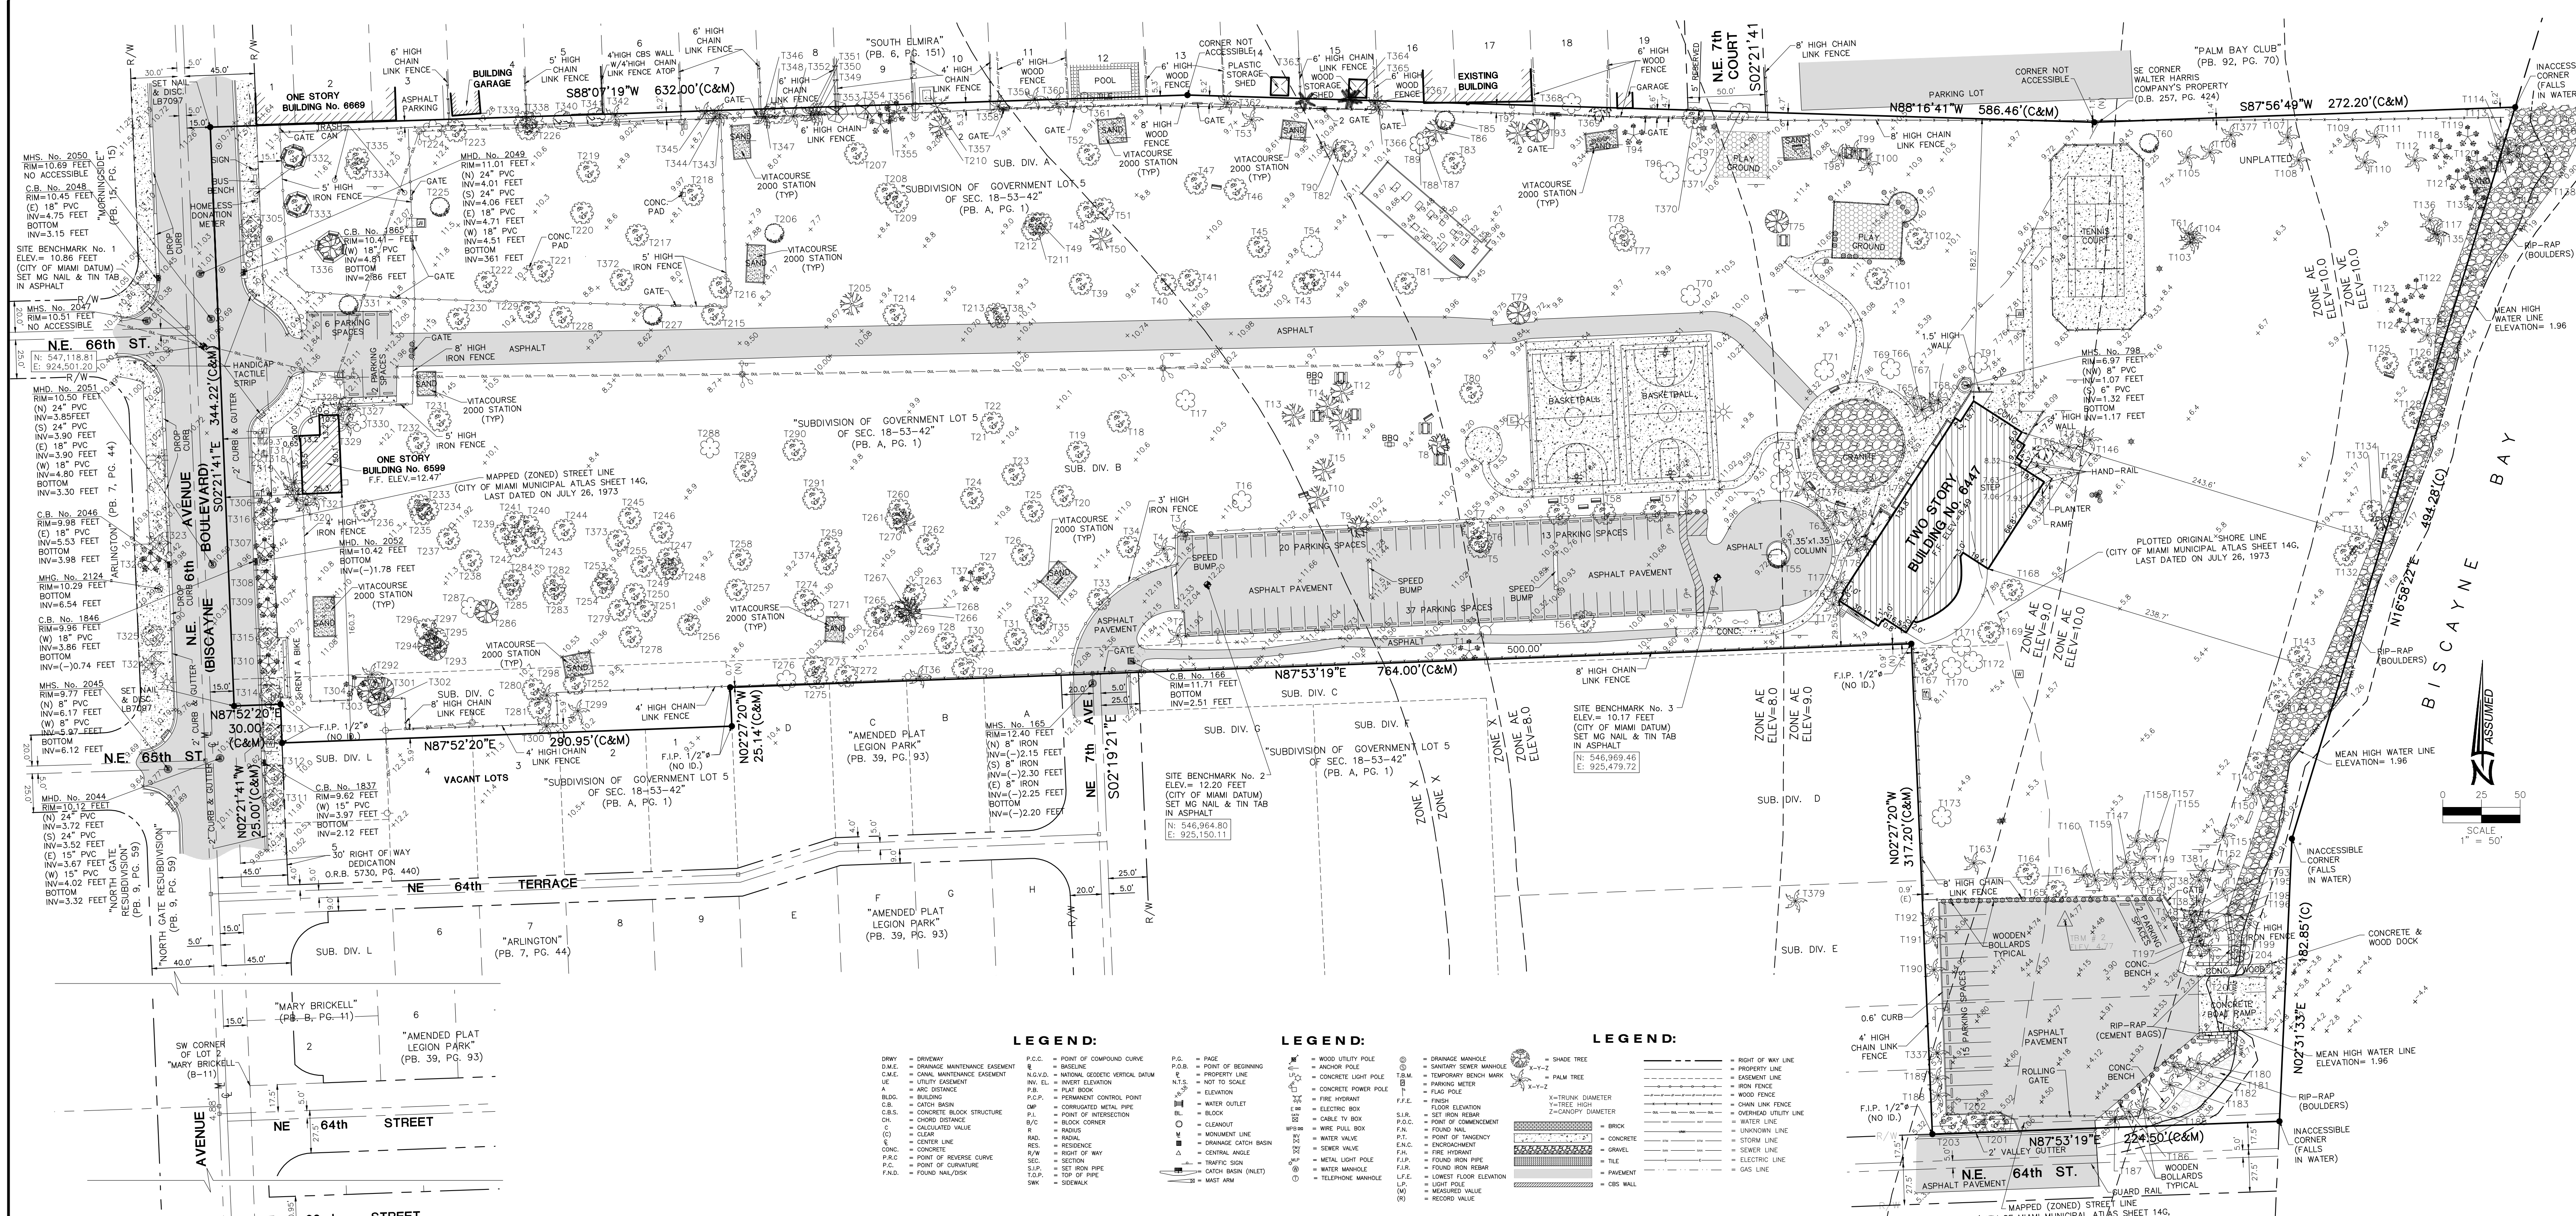

LEGEND:

DRWY = DRIVEWAY
S.M.E. = DRAINAGE MAINTENANCE EASEMENT
C.M.E. = CANAL MAINTENANCE EASEMENT
A.E. = UTILITY EASEMENT
A.R.C. = ARC DISTANCE
C.B. = CONCRETE BLOCK STRUCTURE
C.C. = CHORD DISTANCE
C.V. = CALCULATED VALUE
C.L. = CENTER LINE
C.C. = CONCRETE
R.C. = REINFORCED CONCRETE
P.C. = POINT OF CURVATURE
P.T. = POINT OF TANGENCY
P.O.C. = POINT OF COMPOUND CURVE
N.A.M.E. = NATIONAL GEODETIC VERTICAL DATUM
N.V.D. = NATIONAL VERTICAL DATUM
P.B. = PLAT BOOK
P.C.P. = PERMANENT CONTROL POINT
C.R.P. = CORRUGATED METAL PIPE
C.I.P. = CAST IRON PIPE
R.C. = RADIAL
R.E. = RESIDENCE
R.W. = RIGHT OF WAY
S.E.C. = SECTION
S.P. = SET POINT OF REVERSE CURVE
T.P. = TOP OF PIPE
F.N.D. = FOUND NAIL/DISC

LEGEND:

P.O.B. = POINT OF BEGINNING
P.L. = PROPERTY LINE
P.L. = NOT TO SCALE
ELEVATION
W.O. = WATER OUTLET
W.R.P. = WATER MAIN
C.O. = CLEARED
M.O. = MONUMENT LINE
R.E. = REINFORCED
S.P. = SET POINT OF REVERSE CURVE
S.E.C. = SECTION
T.P. = TOP OF PIPE
M.E. = MEASURED VALUE
R.V. = RECORD VALUE

LEGEND:

WOOD UTILITY POLE
ANCHOR POLE
CONCRETE LIGHT POLE
CONCRETE POWER POLE
FIRE HYDRANT
ELECTRIC BOX
CABLE TV BOX
WIRE PULL BOX
WATER VALVE
METER
SEWER VALVE
METAL LIGHT POLE
WATER MANHOLE
LIGHT POLE
WOOD MANHOLE
SANDWICH SEWER MANHOLE
TEMPORARY BENCH MARK
NOT TO SCALE
FLAG POLE
P.F.F. = FLEXIBLE FLOOR ELEVATION
B.L. = BLOCK
C.O. = CONCRETE
G.R. = GRAVEL
TILE
P.A. = PARALLEL
C.B. = CURB BENCH
C.S. = CURB WALL

LEGEND:

RIGHT OF WAY LINE
PROPERTY LINE
EASEMENT LINE
IRON FENCE
WOOD FENCE
CHAIN LINK FENCE
OVERHEAD UTILITY LINE
WATER LINE
UNDERSIDE UTILITY LINE
STORM LINE
SEWER LINE
ELECTRIC LINE
GAS LINE

| TREE NO. | COMMON NAME | DIAMETER (INCHES) | HEIGHT (FT) | CANOPY (FT) |
|----------|-------------|-------------------|-------------|-------------|
| T11 | GUMBO LIMBO | 24 | 30 | 30 |
| T12 | PALM | 12 | 40 | 15 |
| T13 | PALM | 12 | 40 | 15 |
| T14 | PALM | 12 | 40 | 15 |
| T15 | OKA | 24 | 40 | 30 |
| T16 | OKA | 24 | 40 | 30 |
| T17 | OKA | 24 | 40 | 30 |
| T18 | OKA | 24 | 40 | 30 |
| T19 | OKA | 24 | 40 | 30 |
| T20 | MANGO | 30 | 40 | 30 |
| T21 | MANGO | 30 | 40 | 30 |
| T51 | OKA | 24 | 40 | 30 |
| T52 | OKA | 24 | 40 | 30 |
| T53 | OKA | 24 | 40 | 30 |
| T287 | OKA | 24 | 40 | 30 |
| T288 | | | | |